


COPYING OF THIS DOCUMENT, AND GIVING IT TO OTHERS AND THE USE OR COMMUNICATION OF THE CONTENTS THEREOF, ARE FORBIDDEN WITHOUT EXPRESS AUTHORITY BY Doosan Lentjes GmbH. OFFENDERS ARE LIABLE TO THE PAYMENT OF DAMAGES. ALL RIGHTS TO THIS DOCUMENT AND THE CONTENTS THEREOF ARE RESERVED.

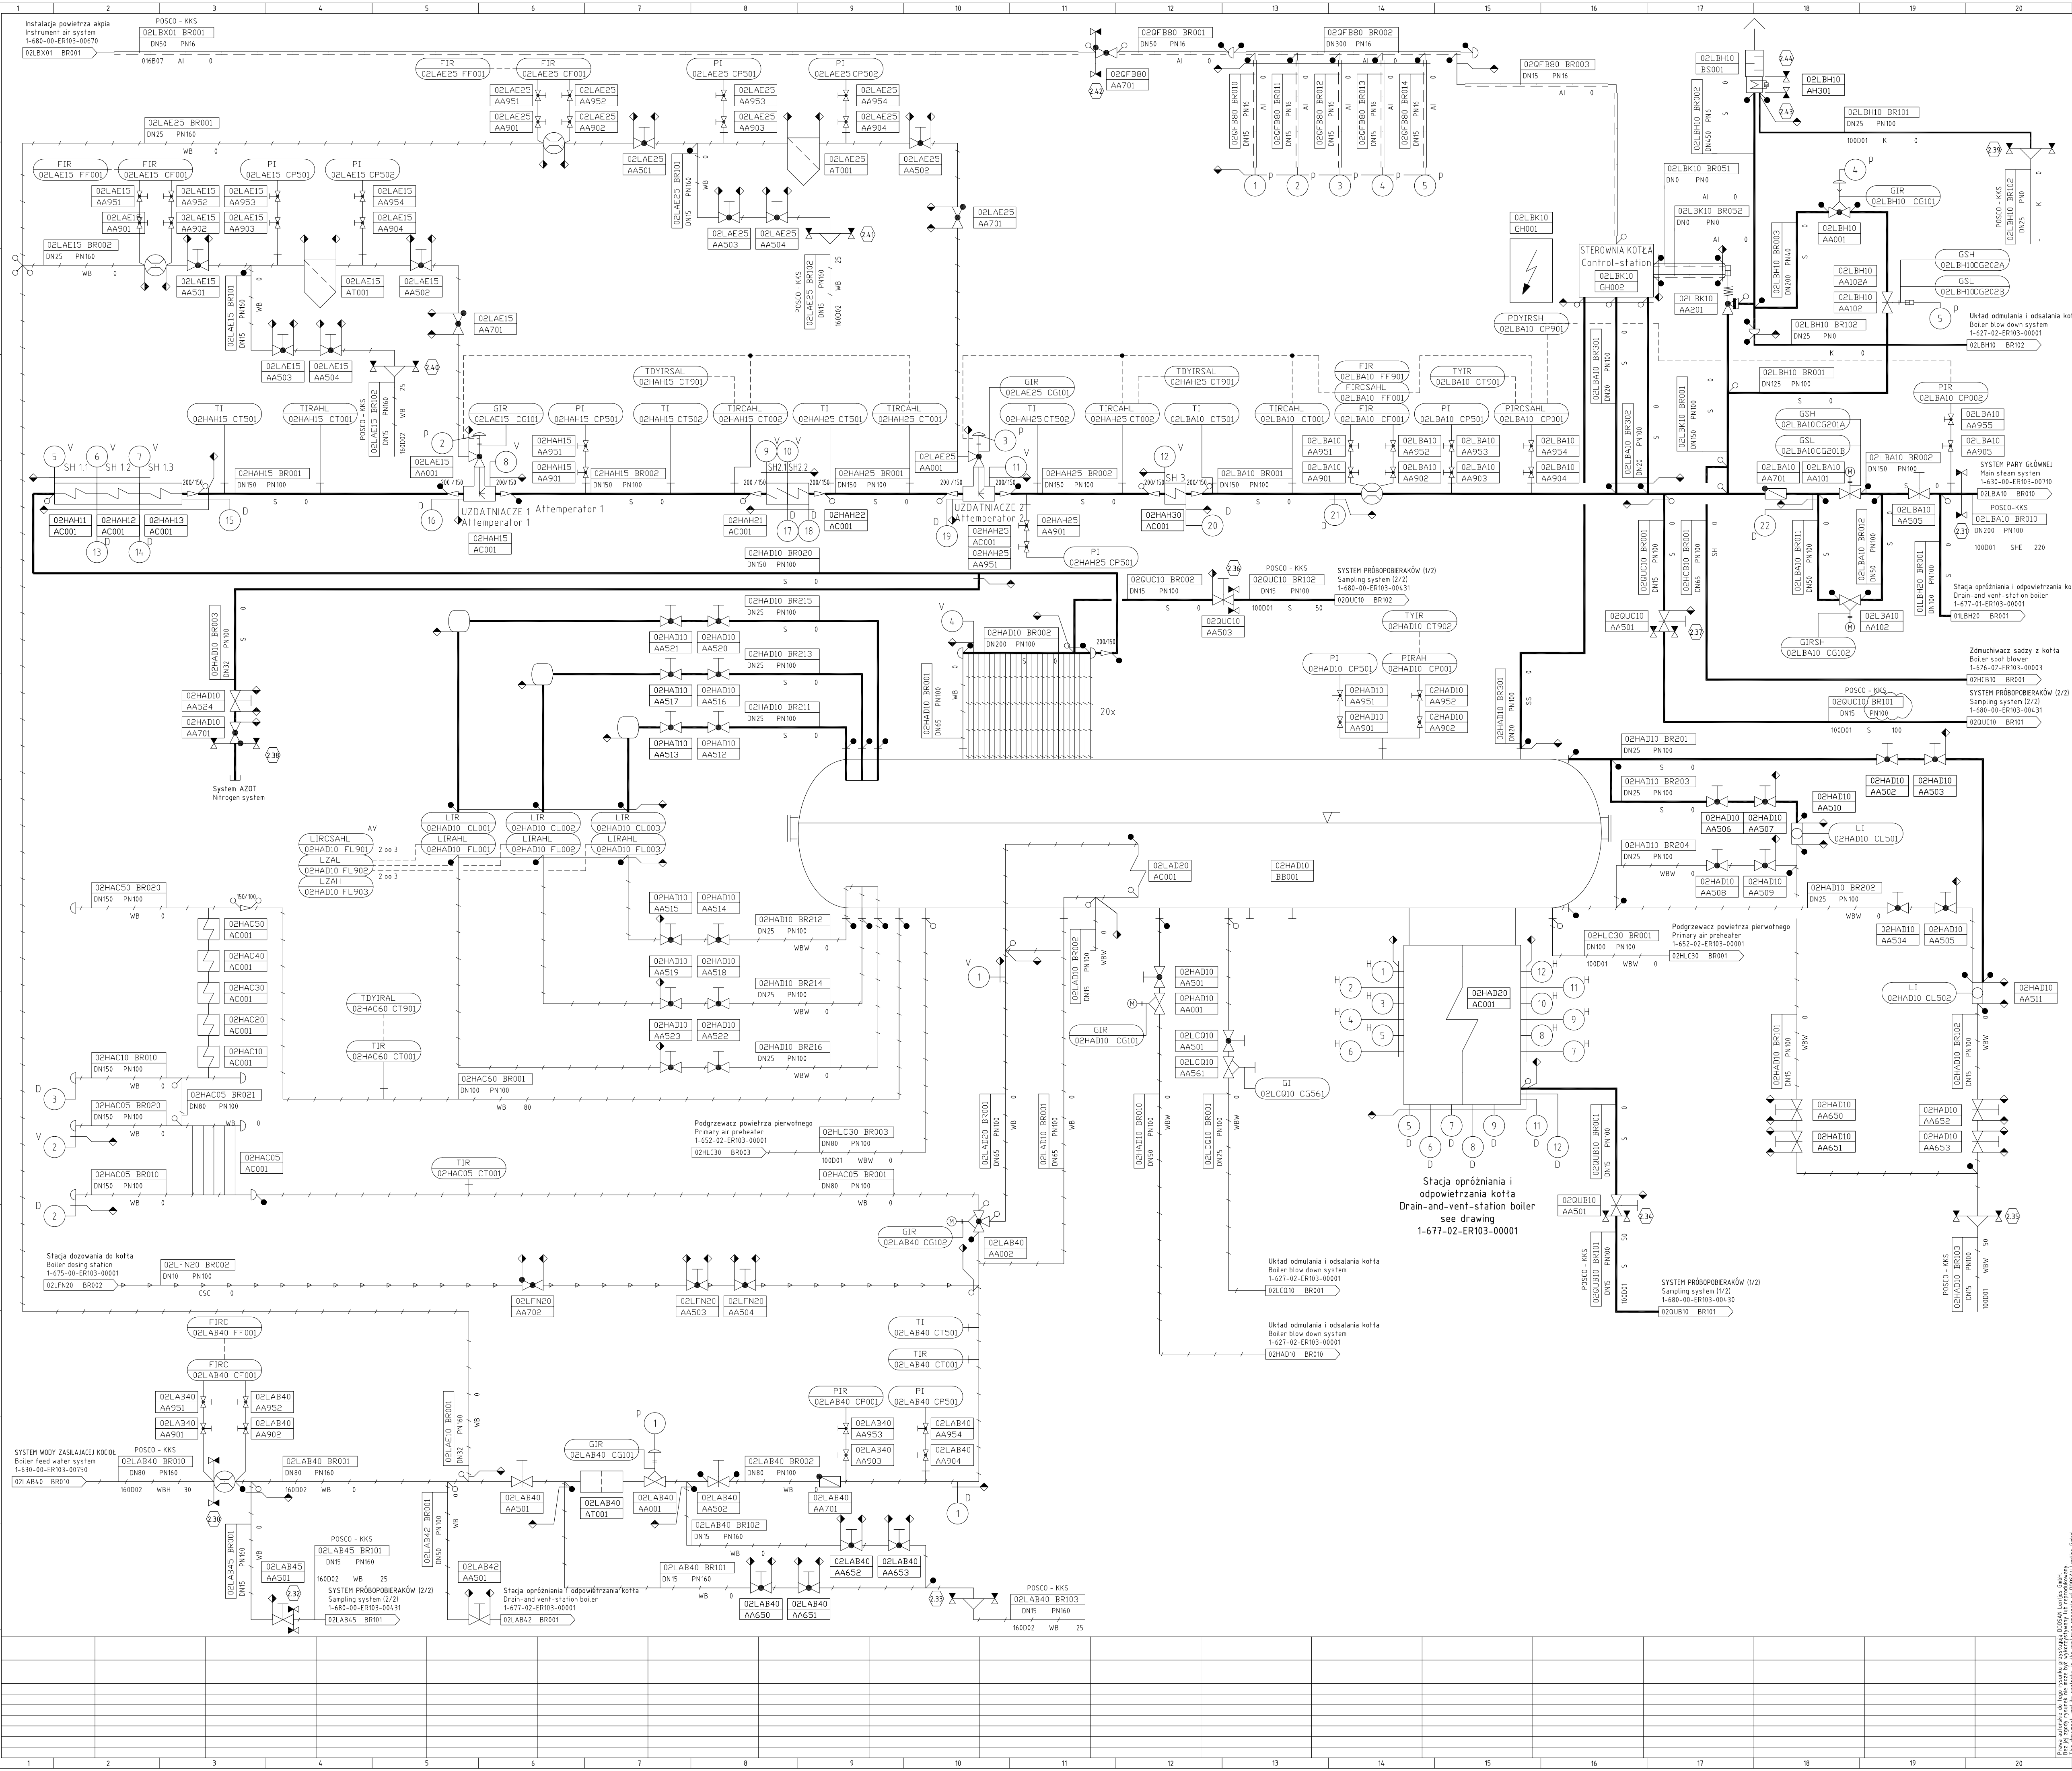

Uwaga:
Note:

Posco E&C Doosan Lentjes
B.L.
Number of battery limit
see Data sheet
"Media Data at battery limit"
(1-620-00-ER40-00002)

Posco E&C Doosan Lentjes
B.L. (-DN50)

V = Odpowietrznik D = Drenaż H = Podgrzewanie wstępne P = Silownik pneumatyczny
V = Vent D = Drain H = Preheating P = Pneumatic actuator

POSCO Engineering & Construction Co., LTD.
KIEROWNIK BUDOWY
Heinz Jürgen GEBHARDT

DOKUMENTACJA
POWYKONAWCZA
AS-BUILT

12.04.2016	As built hot commissioning	Watermann	Kiuth	Samland
04.01.2016	As built cold commissioning	Watermann	Kiuth	Samland
14.04.2015	Design freeze for commissioning	Sawistowski	Hilbert	Samland
19.01.2015	Battery limits acc. to POSCO comments 29.12.2014	Sawistowski	Hilbert	Samland
Rev	Date	Typ zmian	Changes description	Rev'd
1	12.04.2016	As built hot commissioning	Watermann	Kiuth
2	04.01.2016	As built cold commissioning	Watermann	Kiuth
3	14.04.2015	Design freeze for commissioning	Sawistowski	Hilbert
4	19.01.2015	Battery limits acc. to POSCO comments 29.12.2014	Sawistowski	Hilbert
5	12.04.2016	As built hot commissioning	Watermann	Kiuth
6	04.01.2016	As built cold commissioning	Watermann	Kiuth
7	14.04.2015	Design freeze for commissioning	Sawistowski	Hilbert
8	19.01.2015	Battery limits acc. to POSCO comments 29.12.2014	Sawistowski	Hilbert
9	12.04.2016	As built hot commissioning	Watermann	Kiuth
10	04.01.2016	As built cold commissioning	Watermann	Kiuth
11	14.04.2015	Design freeze for commissioning	Sawistowski	Hilbert
12	19.01.2015	Battery limits acc. to POSCO comments 29.12.2014	Sawistowski	Hilbert
13	12.04.2016	As built hot commissioning	Watermann	Kiuth
14	04.01.2016	As built cold commissioning	Watermann	Kiuth
15	14.04.2015	Design freeze for commissioning	Sawistowski	Hilbert
16	19.01.2015	Battery limits acc. to POSCO comments 29.12.2014	Sawistowski	Hilbert
17	12.04.2016	As built hot commissioning	Watermann	Kiuth
18	04.01.2016	As built cold commissioning	Watermann	Kiuth
19	14.04.2015	Design freeze for commissioning	Sawistowski	Hilbert
20	19.01.2015	Battery limits acc. to POSCO comments 29.12.2014	Sawistowski	Hilbert
21	12.04.2016	As built hot commissioning	Watermann	Kiuth
22	04.01.2016	As built cold commissioning	Watermann	Kiuth
23	14.04.2015	Design freeze for commissioning	Sawistowski	Hilbert
24	19.01.2015	Battery limits acc. to POSCO comments 29.12.2014	Sawistowski	Hilbert